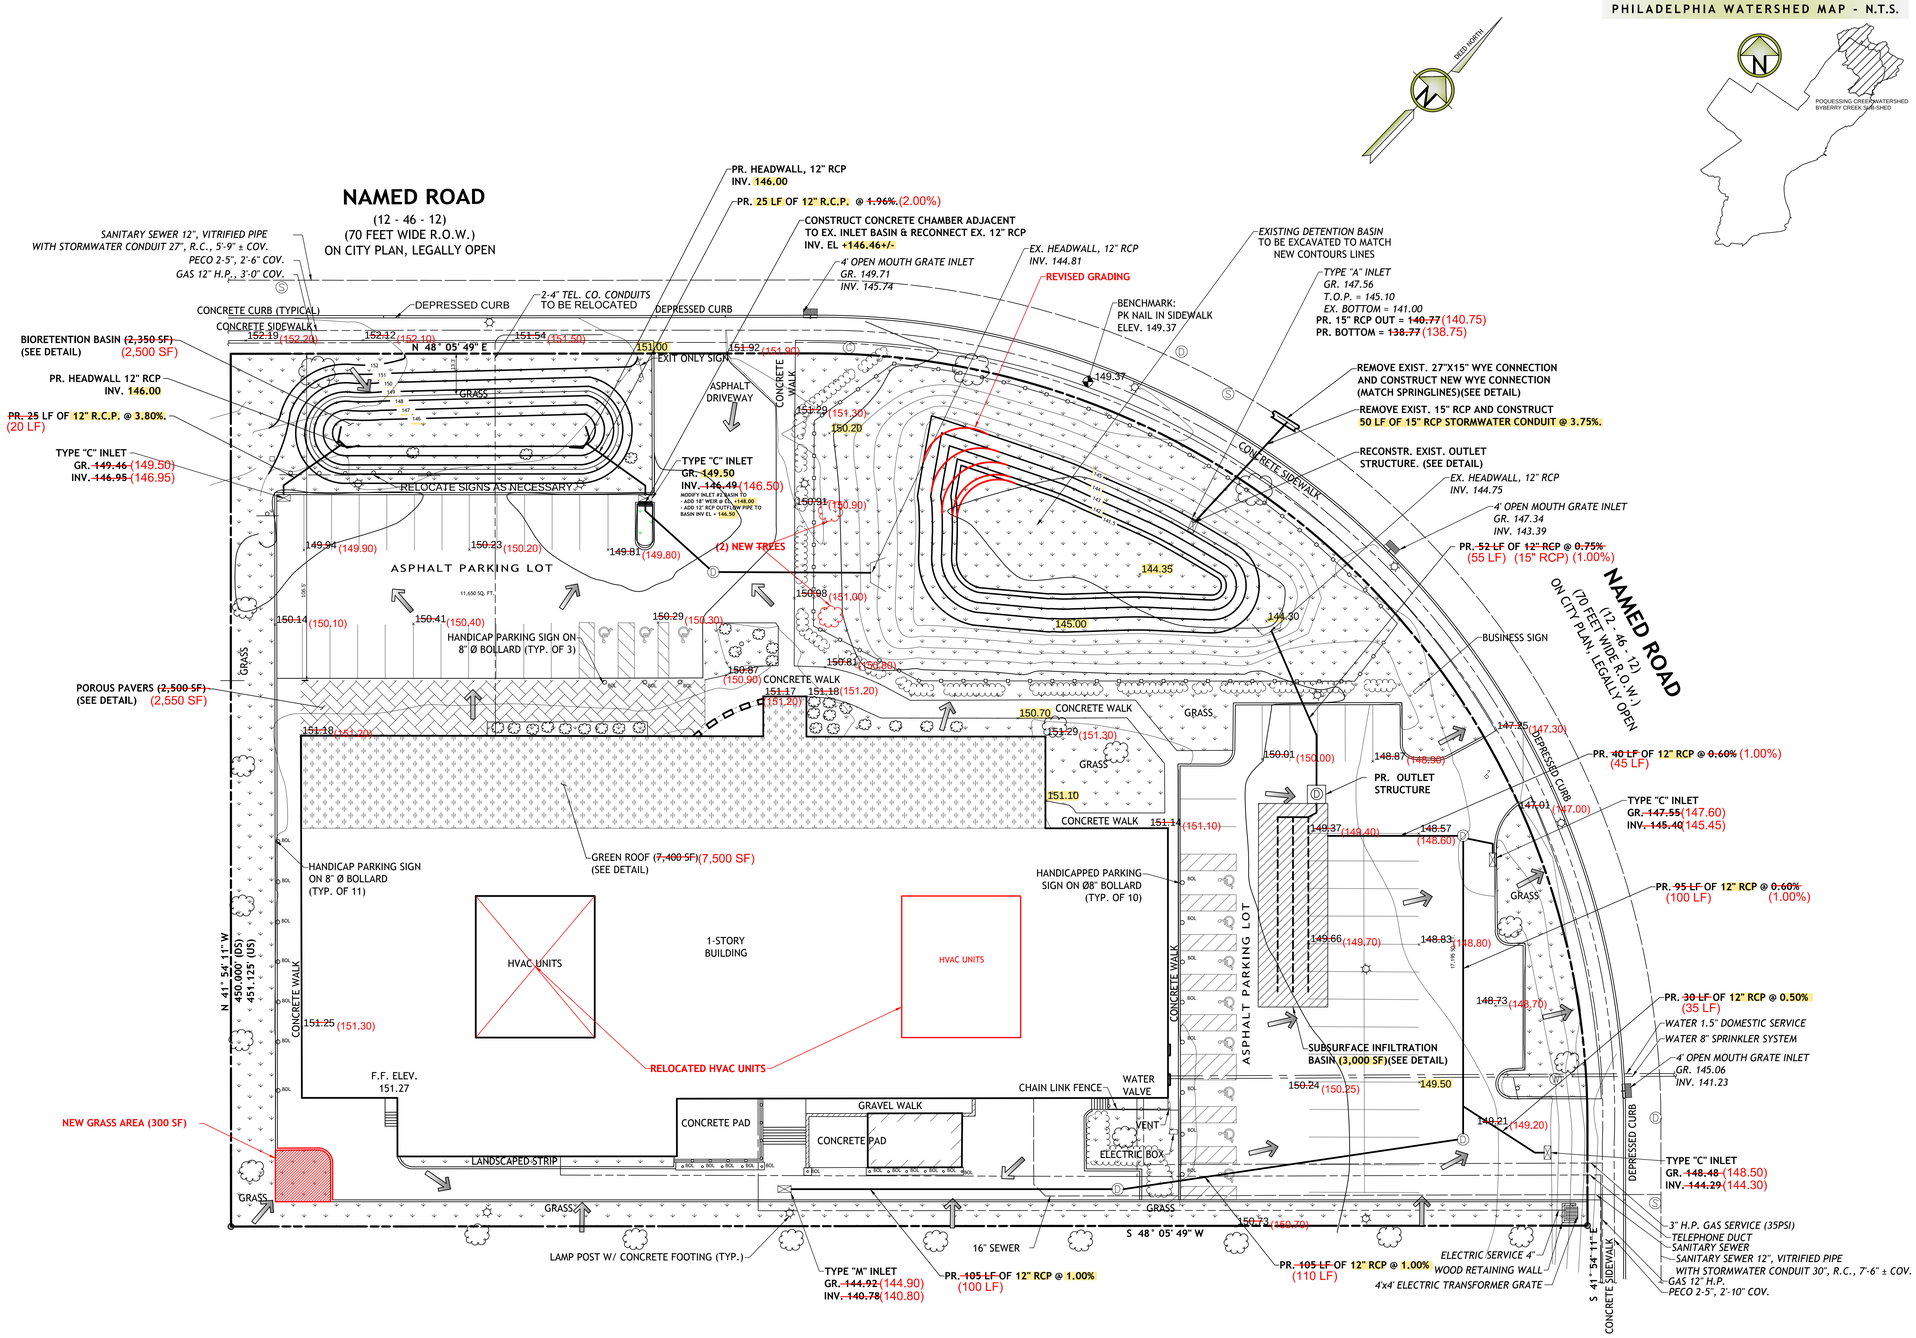

PHILADELPHIA WATERSHED MAP - N.T.S.

LOCATION MAP - N.T.S.

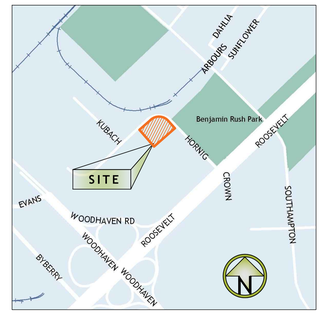

GENERAL NOTES

LEGEND

EXISTING

- PROPERTY BOUNDARY
- METAL FENCE
- 151.00 CONTOUR LINE
- PAVING STRIPING LINE
- VEGETATION LINE / HEDGE
- TC 151.00 TOP OF CURB ELEVATION
- BC 151.00 BOTTOM OF CURB ELEVATION
- x 151.00 SPOT ELEVATION
- INV. INVERT
- GR. GRATE
- DEP. CURB DEPRESSED CURB
- HANDICAPPED RAMP
- FOUND IRON PIN AT PROPERTY CORNER
- DECIDUOUS TREE
- LAMP POST
- FIRE HYDRANT
- Ⓒ COMMUNICATION MANHOLE
- Ⓓ DRAINAGE MANHOLE
- Ⓢ SEWER MANHOLE
- Ⓦ WATER MANHOLE
- WATER VALVE
- GAS VALVE
- WATER BOX
- V VENT BOX-SEWER
- ? UNKNOWN CURB BOX
- BENCHMARK
- TRAFFIC SIGN
- BOLLARD
- HANDICAPPED SYMBOL
- 4" OPEN MOUTH GRATE INLET
- HEADWALL

PROPOSED

- DIRECTION OF FLOW
- INLET
- ASPHALT PAVING
- GREEN ROOF
- GRASS AND LANDSCAPED AREAS
- POROUS PAVERS
- SUBSURFACE INFILTRATION
- 151.00 CONTOUR LINE
- SOLID SEWER PIPE
- PERFORATED SEWER PIPE
- HEADWALL

IMPERVIOUS SURFACES WITHIN PROPERTY LINE

ROOF:
PARKING LOT AND WALKWAYS:
TOTAL IMPERVIOUS AREA:

PWD TRACKING #:

GRAPHIC SCALE

0' 20' 60'
20' 10' 40'
1 INCH = 20 FEET

NO.	DESCRIPTION REVISIONS	DATE	BY

PROFESSIONAL ENGINEER, P.E.
PA Professional Engineer Lic.
No. PE#######
Signature

RECORD DRAWING SAMPLE

PROJECT NAME

Address:	
Drwn/Chk By:	
Municipality: Philadelphia	
County: Philadelphia	
State: Pennsylvania	
Scale: 1" = 20'	
Project Number:	
File Name:	
Field Date:	
Completed:	

Drawing Number:
1 of 2